FILED RECORDERS OFFICE JONES COUNTY IOWA


## 02 JAN 1 | AM 10: 30


MARIE KRUTZFIELD RECORDER 6.00 Pd

Prepared by: SCHNEIDER Land Surveying and Planning P.O. Box 105 Peosta, Iowa 52068 UNITED STATES PUBLIC LAND SURVEY CORNER CERTIFICATE OF Land Survey Monuments situated in Section 31, Township 86 North, Range 4 West of the Fifth Principal Meridian, Jones County, Iowa.

Previously recorded <u>IN BOOK 338, PAGE 47 (NE COR. SEC. 31.</u>

6800K, PAGE / INST. NO. / CASINET, BLIDE) <u>aka SE COA. SEC. 30)</u>. (Show reason for preparing this certificate, the evidence and detailed procedures used in establishing the corner positions and monumentation found or placed.) Monument Description and Remarks: THE NE CORNER OF SEC. 31-T86N-R4W WAS RETIED AS IT WAS FOUND. ONE TIE HAD BEEN CHANGED AND MORE TIES WERE ADDED. NO MONUMENT WAS FOUND AT THE E1/4 CORNER OF SEC. A 1/2" REBAR W/ YELLOW CAP #14417 WAS PLACED AT A SPLIT OF THE ROAD BED AND R.O.W. FENCES. PLACED IN LINE WITH THE OCCUPATION FENCE LOCATED EAST OF THE CORNER. A 5/8" REBAR WAS FOUND IN THE GRAVEL ROAD AT THE SE CORNER OF SEC. 31-T86N-R4W. THE REBAR WAS ACCEPTED AS THE CORNER AND REFERENCE TIED PLAN - VIEW (Show a minimum of three reference ties to durable physical objects, relevant monuments and physical conditions that will enable recovery of the corner.) FACE OF METAL CORNER POST AVENUE FOUND 'X' NAILS IN POWER POLE Ø 62.08° ET MAG HALL THE SECONTY ROAD , <u>65</u> E-16

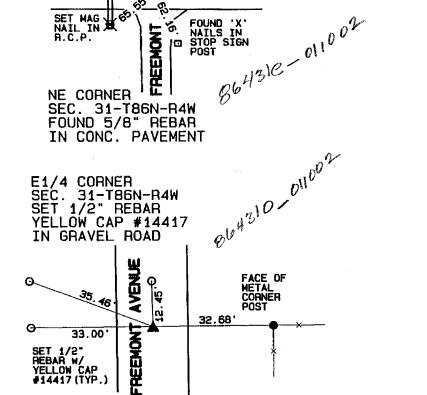

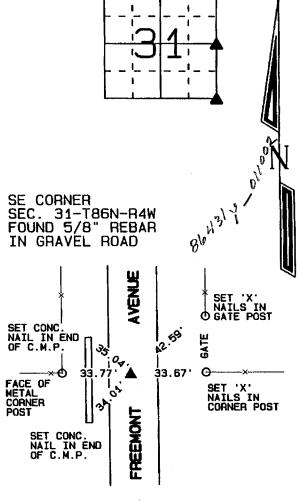

I hereby certify that this land surveying document was
prepared and the related survey work was performed by
me or under my direct personal supervision and that I
am a duly licensed Land Surveyor under the laws of the
State of Iowa.

David P. Schneider P.L.S. #14417 Oate My license renewal date is December 31, 2003.

Pages or sheets covered by this seal: THIS SHEET ONLY

SCHNEIDER Land Surveying & Planning P.O. Box 105 Peosta, Iowa 52068 Ph. #563-556-9055 Fax#563-556-9054



	List	Corners	to	þe	Index	ea
Corners		Section		Twp		Range
NE		31		88	5N	4W
E1/4		31		86	6N	4W
SE		31		86	5N	4W

JOB NO. 278