Junes County Marie Krutzfield Recorder Fee Book 2011 1448 06/02/2011 @0159PM # Pages 1 ZSC SEC COR CERT CERT 50.00 Total Fees:


> 19501 HWY. 64, ANAMOSA, IOWA 52205 (319) 462-3785

PREPARED BY

CLARENCE J. WALTON, JONES COUNTY ENGINEER'S OFFICE, 19501 HWY. 64, ANAMOSA, IOWA, 52205 (319) 462-3785

UNITED STATES PUBLIC LAND SURVEY CORNER CERTIFICATE

LAND SURVEY MONUMENTS SITUATED IN SECTION 35, TOWNSHIP 85 NORTH,

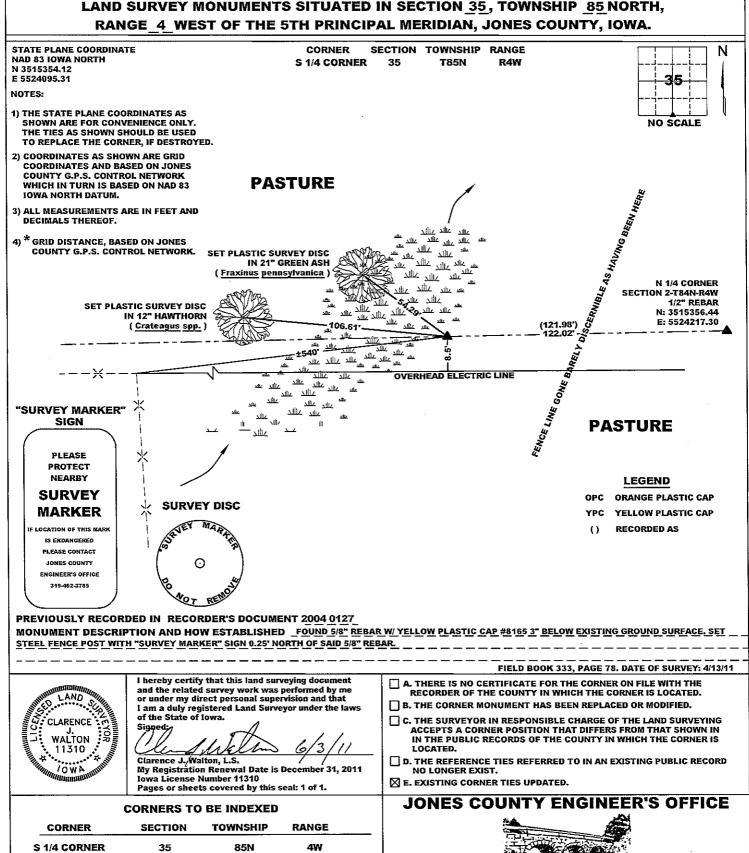

2004 0127 ONLY FILEU RECORDERS OFFICE JONES COUNTY IOWA USE RECORDER 04 JAN 13 AM 11: 17 MARIE KRUTZFIELD RECORDER 11.00 pd FOR PREPARED BY: MMS CONSULTANTS INC. - 1917 S. GILBERT STREET - IOWA CITY, IOWA, 52240 - (319)351-8282 U.S. PUBLIC LAND SURVEY CORNER FOR LAND SURVEY MONUMENTS SITUATED IN SECTION 35, TOWNSHIP 85 NORTH, RANGE 4 WEST, OF THE FIFTH PRINCIPAL MERIDIAN, JONES COUNTY, IOWA REASON FOR PREPARING CERTIFICATE: THERE IS NO CERTIFICATE FOR THE CORNER ON FILE WITH THE RECORDER. INSTRUMENT NO. 9899 1023 CORNER FOUND DIFFERS FROM PREVIOUSLY RECORDED CERTIFICATE RECORDED IN BOOK RECOVERY TIE DRAWING S 1/4 CORNER **35 - 85** 6"ø FND. 1/2" Ø PIN TREE W/YELLOW CAP 85435w-010904 # 8165, FLUSH N 1/4 2-84-4 LOCATION 121.87'(R) TREE 121.98'(M) · 88.04. POWER POLE FND. 5/8" Ø PIN W/YELLOW MMS CAP # 8165, FLUSH S 1/4 34-85-4 MMS TIE DISC W/NAIL (TYP.) MONUMENT DESCRIPTION AND REMARKS : MONUMENT DESCRIPTION AND REMARKS: FND. 5/8" Ø PIN W/YELLOW MMS CAP # 8165, FLUSH WITH THE GROUND, TIES FROM THE RECORDED TIE IN INSTRUMENT NUMBER 9899 1023, WERE DESTORYED, SO NEW TIES WERE SET. I HEREBY CERTIFY THAT THE CORNER LOCATION(S) SHOWN ON THIS RECORD WERE DETERMINED BY ME OR UNDER MY DIRECT PERSONAL SUPERVISION AND THAT THIS U.S. PUBLIC LAND SURVEY MONUMENT RECORD IS CORRECT AND COMPLETE TO THE BEST OF MY KNOWLEDGE AND BELIEF. 1-9-04 GLEN D. MEISNER, PE & PLS Iowa License No. 8165 MY BIENNIAL RENEWAL DATE IS DECEMBER 31, 2005 SHEET U.S. PUBLIC LAND SURVEY CORNER CERTIFICATE GOVERNMENT CORNER MMS Consultants, Inc. O 5/8" TIE PIN SET Iowa City, Iowa — CENTERLINE CARROLL HUMPAL **PROJECT** - EXISTING FENCE LINE 319-351-8282 JONES COUNTY, IOWA - R.O.W. LINE PROJECT NO. CHECKED BY: APPROVED BY: DATE SCALE FIELD BOOK DRAWN BY: GDM 4470-016 RLS RLS NONE 704 1-9-04

J

LAND SURVEY MONUMENTS SITUATED IN SECTION 2. TOWNSHIP 84 NORTH, RANGE 4 WEST, OF THE FIFTH PRINCIPAL MERIDIAN, JONES, COUNTY, IOWA. PREVIOUSLY RECORDED IN BOOK AT PAGE FOR RECORDER'S USE REASON FOR PREPARING CATRICATE: A) THERE IS NO CERTIFICATE FOR THE CORNER ON FILE WITH THE RECORDER OF THE COUNTY IN WHICH THE CORNER IS LOCATED. G) CHE COUNTY IN WHICH THE CORNER IS LOCATED. G) THE COUNTY IN WHICH THE CORNER IS LOCATED. THE COUNTY IN WHICH THE CORNER LOCATEDIAN IS LOCATED. THE COUNTY IN WHICH THE CORNER LOCATEDIAN IS LOWER IN THE CORNER IS LOCATED. THE COUNTY IN WHICH THE CORNER LOCATEDIAN IS CONTROL AND CONTR	SECTION CORNER CERTIFICATE
REASON FOR PREPARING CERTIFICATE: MA THERE IS NO CERTIFICATE FOR THE CORNER ON FILE WITH THE RECORDER OF THE COUNTY IN WHICH THE CORNER IS LOCATED. OF THE COUNTY IN WHICH THE COUNTY IN THE CORNER IS LOCATED. OF THE COUNTY IN WHICH THE COUNTY IN THE CORNER IS LOCATED. OF THE	LAND SURVEY MONUMENTS SITUATED IN SECTION 2, TOWNSHIP 84 NORTH, RANGE 4 WEST, OF THE FIFTH PRINCIPAL MERIDIAN, JONES, COUNTY, IOWA.
THERE IS NO CERTIFICATE FOR THE CORNER ON FILE WITH THE RECORDER OF THE COUNTY IN WHICH THE CORNER IS LOCATED. B) CORNER POSITION DIFFERS FROM THAT SHOWN IN THE PUBLIC RECORDS OF THE COUNTY IN WHICH THE CORNER IS LOCATED. THE CORNER MONUMENT HAS BEEN REPLACED OR MODIFFED. THE CORNER MONUMENT HAS BEEN REPLACED OR MODIFFED. THE REFERENCE TES REFERRED TO IN AN EXISTINC PUBLIC RECORD ARE INCORRECT. MONUMENT DESCRIPTION AND REMARKS: M.W. CARNER SECTION 2-TB4N-R4W SET Z. REBAR W/ LS. CAP # BIGS FLUSH W/ GROUND 42 NORTH OF EAST-WEST FC. N'4 CORNER SECTION 2-TB4N-R4W SET Z. REBAR W/ LS. CAP # BIGS 4" DEEP RECOVERY TIE DRAWING N.W. COR. Z-84-4 INCORPORT SECTION TO THE DRAWING N.W. COR. Z-84-4 I GLEN D. MEISNERCERTIFY THAT THE CORNER LOCATION(S) SHOWN ON THIS RECORD WERE-DETERMINED BY ME OR UNDER MY DIRECTION AND CONTROL AND THAT, THIS U.S. PUBLIC LAND SURVEY MONUMENT RECORD IS CORRECT AND COMPLETE RESORD WERE-DETERMINED BY ME OR UNDER MY DIRECTION AND CONTROL AND THAT, THIS U.S. PUBLIC LAND SURVEY MONUMENT RECORD IS CORRECT AND COMPLETE RESORD WERE-DETERMINED BY ME OR UNDER MY DIRECTION AND CONTROL AND THAT, THIS U.S. PUBLIC LAND SURVEY RECORD THAT, THIS U.S. PUBLIC LAND SURVEY RECORD THE COUNTY OF THE DESCRIPTION OF THE CORNER LOCATION S.E. CEDAR RAPIDS. 100M 32403 313-35-35-95-84	PREVIOUSLY RECORDED IN BOOK AT PAGE FOR RECORDER'S USE
N. W. CORNER SECTION Z-TBQN-RQW SET Z' REBAR U/ C.S. CAP # 8165 FLUSH W/ GROUND Q'Z' NORTH OF EAST-WEST FC. N. 4 CORNER SECTION Z-TBQN-RQW SET Z' REBAR W/ C.S. CAP # 8165 Q' DEEP RECOVERY TIE DRAWING N.W. COR. Z-84-4 N.Y. COR. Z-84-4 N.Y. COR. Z-84-4 N.Y. COR. Z-84-4 SET Z' REBAR W/ CAP N.W. COR. Z-84-4 N.W. COR. Z-84-4 SET Z' REBAR W/ CAP N.W. COR. Z-84-4 N.W. COR. Z-84-4 SET Z' REBAR W/ CAP N.W. COR. Z-84-4 N.W. C	OF THE COUNTY IN WHICH THE CORNER IS LOCATED. B) CORNER POSITION DIFFERS FROM THAT SHOWN IN THE PUBLIC RECORDS OF THE COUNTY IN WHICH THE CORNER IS LOCATED. '> THE CORNER MONUMENT HAS BEEN REPLACED OR MODIFIED. D) THE REFERENCE TIES REFERRED TO IN AN EXISTING PUBLIC RECORD ARE
EAST - WEST FC. N'4 CORNER SECTION Z - TB4 N- R4 W SET Z" REBAR W/ LS. CAP # BIGS 4" DEEP RECOVERY TIE DRAWING N.W. COR. Z-84-4 SET Z" REBAR W/ CAP REBAR W/ CAP REBAR W/ CAP I, GLEN D. MEISNERCERTIFY THAT THE CORNER LOCATION(S) SHOWN ON THIS RECORD WERE DETERMINED BY ME OR UNDER MY DIRECTION AND CONTROL AND THAT THIS U.S. PUDLIC LAND SURVEY MONUMENT RECORD IS CORRECT AND COMPLETE A D. MEISNER GLEN D. MEISNER GLE	MONUMENT DESCRIPTION AND REMARKS:
RECOVERY TIE DRAWING N.W. COR. Z-84-4 SET 'Z' REBAR W/CAP N'4 COR. Z-84-4 N'4 COR. Z-84-4 N'4 COR. Z-84-4 N'4 COR. Z-84-4 SET Z' REBAR W/CAP NO CARD ME GRE. SEC. SO NO CARD ME SEC. SEC. SO NO CARD ME GRE. SEC. S	W/ C.S. CAP # 8165 FLUSH W/ GROUND 4'Z' NORTH OF
RECOVERY TIE DRAWING N.W. COR. Z-84-4 N.4 COR. Z-84-4 REBAR W/CAP NOTICE LINES REBAR W/CAP N. W. CAR N. W. CAR REBAR W/CAP N. W. CAR REBAR W/CAP N. W. CAR REBAR W/CAP N. W. CAR N. W. CAR N. W. CAR REBAR W/CAP N. W. CAR N. W. CAR N. W. CAR REBAR W/CAP N. W. CAR N. W. CA	N'4 CORNER SECTION Z-TB4N-R4W SET 'Z" REBAR
N.W. COR. Z-84-4 SET Z REBAR N 4 COR. Z-84-4 SET Z REBAR N/CAP SEC. 204 SEC. 34-85-4 POLE IN CARD ME GRE SEC. 9 IN CARD ME GRE SEC. 9 IN CARD MESNERCERTIFY THAT THE CORNER LOCATION(S) SHOWN ON THIS RECORD WERE. DETERMINED BY ME OR UNDER MY DIRECTION AND CONTROL AND THAT THIS US. PUBLIC LAND SURVEY MONUMENT RECORD IS CORRECT AND COMPLETE OF THE DEST OF MY KNOWLEDGE AND BELIEF. A CONCAMADITI COMMIT OF THE DEST OF MY KNOWLEDGE AND BELIEF. A CONCAMADITI COMMIT OF THE DEST OF MY KNOWLEDGE AND BELIEF. A CONCAMADITI COMMIT OF THE DEST OF MY KNOWLEDGE AND BELIEF. A CONCAMADITI COMMIT OF THE DEST OF MY KNOWLEDGE AND BELIEF. A CONCAMADITI COMMIT OF THE DEST OF MY KNOWLEDGE AND BELIEF. A CONCAMADITI COMMIT OF THE DEST OF MY KNOWLEDGE AND BELIEF. A CONCAMADITI COMMIT OF THE DEST OF MY KNOWLEDGE AND BELIEF. A CONCAMADITI COMMIT OF THE DEST OF MY KNOWLEDGE AND BELIEF. A CONCAMADITI COMMIT OF THE DEST OF MY KNOWLEDGE AND BELIEF. A CONCAMADITI COMMIT OF THE DEST OF MY KNOWLEDGE AND BELIEF. A CONCAMADITI COMMIT OF THE DEST OF MY KNOWLEDGE AND BELIEF. A CONCAMADITI COMMIT OF THE DEST OF MY KNOWLEDGE AND BELIEF. A CONCAMADITI COMMIT OF THE DEST OF MY KNOWLEDGE AND BELIEF. A CONCAMADITI COMMIT OF THE DEST OF MY KNOWLEDGE AND BELIEF. A CONCAMADITI COMMIT OF THE DEST OF MY KNOWLEDGE AND BELIEF. A CONCAMADITI COMMIT OF THE DEST OF MY KNOWLEDGE AND BELIEF. OF THE DEST OF MY KNOWLEDGE	
REBAR W/CAP SEC. Sec. 34-85-4 FC. POST I, GLEN D. MEISNERCERTIFY THAT THE CORNER LOCATION(S) SHOWN ON THIS RECORD WERE DETERMINED BY ME OR UNDER MY DIRECTION AND CONTROL AND THAT THIS U.S. PUBLIC LAND SURVEY MONUMENT RECORD IS CORRECT AND COMPLETE TO THE DEST OF MY KNOWLEDGE AND BELIEF. L. A. COMMINIONI CONTROL NO. STATE TO THE DEST OF MY KNOWLEDGE AND BELIEF. L. A. COMMINIONI CONTROL NO. STATE TO THE DEST OF MY KNOWLEDGE AND BELIEF. L. A. COMMINIONI CONTROL NO. STATE TO THE DEST OF MY KNOWLEDGE AND BELIEF. L. A. COMMINIONI CONTROL NO. STATE TO THE DEST OF MY KNOWLEDGE AND BELIEF. L. A. COMMINIONI CONTROL NO. STATE TO THE DEST OF MY KNOWLEDGE AND BELIEF. L. A. COMMINIONI CONTROL NO. STATE TO THE DEST OF MY KNOWLEDGE AND BELIEF. L. A. COMMINIONI CONTROL NO. STATE TO THE DEST OF MY KNOWLEDGE AND BELIEF. L. A. COMMINIONI CONTROL NO. STATE TO THE DEST OF MY KNOWLEDGE AND BELIEF. L. A. COMMINIONI CONTROL NO. STATE TO THE DEST OF MY KNOWLEDGE AND BELIEF. L. A. COMMINIONI CONTROL NO. STATE TO THE DEST OF MY KNOWLEDGE AND BELIEF. L. A. COMMINIONI CONTROL NO. STATE TO THE DEST OF MY KNOWLEDGE AND BELIEF. L. A. COMMINIONI CONTROL NO. STATE TO THE DEST OF MY KNOWLEDGE AND BELIEF. L. A. COMMINIONI CONTROL NO. STATE TO THE DEST OF MY KNOWLEDGE AND BELIEF. FD. CSNC. 35-15-5 NO CARD ME CSR. SEC. 3 I, GLEN D. MEISNERCERTIFY THAT THE CORNER LOCATION(S) SHOWN ON THIS RECORD WERE-DETERMINED BY ME OR UNDER MY DIRECTION AND CONTROL AND THAT/THIS U.S. PUBLIC LAND SURVEY MONUMENT RECORD IS CORRECT AND COMPLETE TO THE DEST OF MY KNOWLEDGE AND BELIEF. ACCURATION LOCATION SEC. 34-85-4 FD. CSNC. 35-15-5 WE BAR W/ CAP NO CSNC. 35-15-5 NO CARD ME CSNC. 35-15-5 NO C	N.W. COR. Z-84-4
I, GLEN D. MEISNER CERTIFY THAT THE CORNER LOCATION(S) SHOWN ON THIS RECORD WERE DETERMINED BY ME OR UNDER MY DIRECTION AND CONTROL AND THAT THIS U.S. PUBLIC LAND SURVEY MONUMENT RECORD IS CORRECT AND COMPLETE TO THE DEST OF MY KNOWLEDGE AND BELIEF. B165 COVERNMENT CORNER TALL CONTROL C	REBAR W/CAP SEC. 34.85.4 FD. CONC. MON QUILLE LINES TELE. LINES XYNAIL FC. POST ON CARD Nº GOR. SEC. 8 PREBAR W/CAP TELE. LINES XYNAIL FC. POST ON CARD Nº GOR. SEC. 8
Sys TK PRI SCT CENTRIUNC CONTRIUNC CONTRIUNC CENTRIUNC CEDAR RAPIDS, IOWA 52403 319-362-9548	I, GLEN D. MEISNERCERTIFY THAT THE CORNER LOCATION(S) SHOWN ON THIS RECORD WERE DETERMINED BY ME OR UNDER MY DIRECTION AND CONTROL AND THAT THIS U.S. PUBLIC LAND SURVEY MONUMENT RECORD IS CORRECT AND COMPLETE TO THE BEST OF MY KNOWLEDGE AND BELIEF. 6-29-93
D XUIL UNI 119-362-9548	Syst Tic PIN SCT U.S. PUBLIC LAND SURVEY RECORD HALL AND HALL ENGINEERS, INC. CONTRING CONTRIN
	0 KUIL LINE / / A R C G DEN S URVEY 519-362-9548

84403e-062993. 84402c-062993

98 99 1023 FILED 98
RECORDERS OFFICE
JONES COUNTY IOWA

98 SEP 21 PM 12: 01

MARIE KRUTZFIELD RECORDER 6-00 Pd

