FILED
RECORDERS OFFICE
JONES COUNTY IOWA


05 JAN 14 PM 1: 34

MARIE KRUTZFIELD RECORDER No Fee

J.D. TJEPKES, LS. JONES COUNTY ENGINEER'S OFFICE, 19501 HWY. 64, ANAMOSA, IOWA, 52205 (319)462-3785

UNITED STATES PUBLIC LAND SURVEY CORNER CERTIFICATE

LAND SURVEY MONUMENTS SITUATED IN SECTION 12, TOWNSHIP 83 NORTH, RANGE 4 WEST OF THE 5TH P.M., JONES COUNTY, IOWA

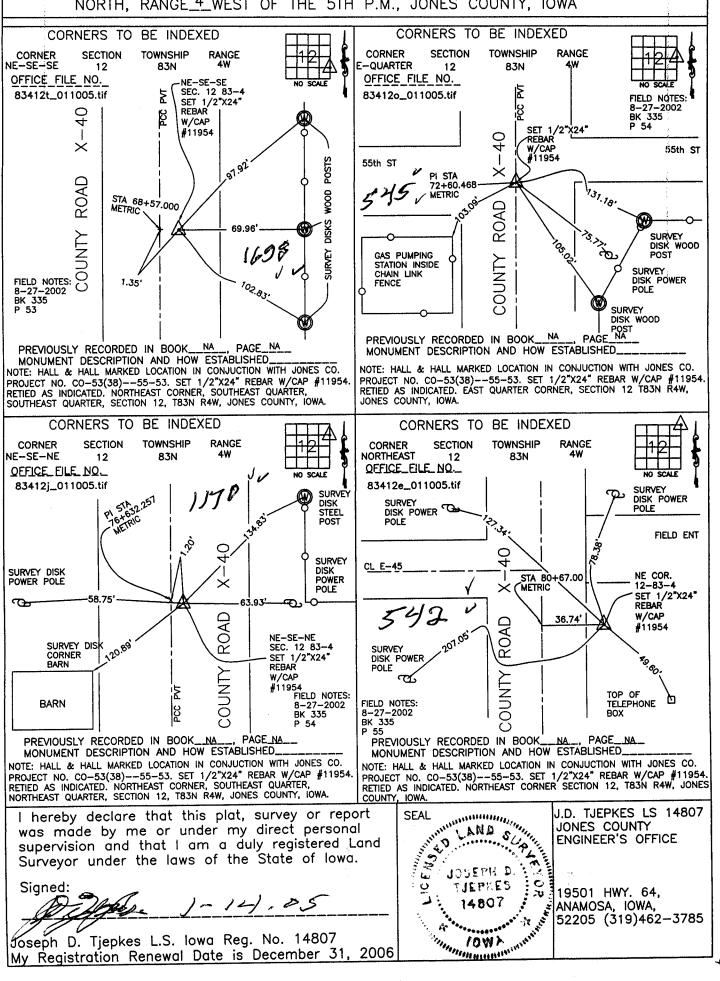

2003 1051 FILED RECORDERS OFFICE JONES COUNTY 19WA

03 MAR 13 PM 12: 53


MARIE KRUTZFIELD


				אבטטאנ	-				
LAND SU	KAFA WOUN	ALL ENGINEERS, INC.	IN SEC	TION	1	TOWA	WA 52402 (319) 3 SHIP <u>8</u> 3	52-9548 NORTH,	
RANGE 4 WEST, OF THE FIFTH PRINCIPAL RECOVERY TIE DRAWING					MERIDIAN, JONES COUNTY IOWA.				
HALL AND HALL SURVEY				MONUMENT DESCRIPTION AND REMARKS: NE COR1/41/4, SEC. 1_, T83 N, R4W					
44.09	——————————————————————————————————————	LLANDHALL SOLVEY SKIN POLVER POLE	> -		REASON PREVIOU ラピナリ	FOR PREPAR	RING CERTIFICATE:	A) B, C OR D	
4 HEW	PORT ROAD		CORNI	R INDEX _					
HALL AND HALL SU DISK IN WOOD FOR		FEILD DELVE E E 45	CORNE	, k	REASON PREVIOUS FOUN	FOR PREPAR	ING CERTIFICATE: /		
HALL AND HALL SIEVE DISK IN CORNER PO	oz: -	FELLO 12:	39 33 703		83	4120	:_01)3p	3	
HALL AND HALL DIS IN POWER POLE 127.22' & COUNTY ROSTE E 45.	ROJE X 40	76.30°	ر 'ی		EASON I REVIOUS	FOR PREPARI BOOK /Z' REWAR ' EAST O	NG CERTIFICATE:	. CAP#11954,	
334014 HALL HALL DISK									
DANIEL J. Dan My	I hereby certify that this land surveying document was prepared and the related survey work was performed by one or under my direct personal supervision and that I am a duly licensed Land Surveyor under the laws of the State of Iowa. Date: Date:						THE CORNER ON HE COUNTY ATED. M THAT SHOWN HE COUNTY IN D HEEN REPLACED		
Sheet Title: U.S. PUBLIC LAND SURVEY CORNER CERTIFICATE Project Title: X - 40 HALL AND HALL ENGINEERS, IN 209 29TH STREET N.E. CEDAR RAPIDS, IOWA 52402 (319) 362-9548							GINEERS, INC.		
	ed by:	Approved by:	Field Book	i i	Scale:	NONE	Date: 2/13/03	Project No: Col 25	

UNITED STATES PUBLIC LAND SURVEY CORNER CERTIFICATE OF


LAND SURVEY MONUMENTS SITUATED IN SECTION 6 __, TOWNSHIP __*83_NORTH__*, RANGE 3 WEST , OF THE 5TH PRINCIPAL MERIDIAN____ JONES COUNTY IOWA. OES NOT PPLY
(book, page, document number, etc.) PREVIOUSLY RECORDED IN DOES IN COUNTY RECORDER'S OFFICE. (Show reason for preparing this certificate, the evidence and detailed procedures used in establishing the corner positions and monumentation found or placed.) MONUMENT DESCRIPTION AND REMARKS: <u>PE-ESTABLISHED SW COR FROM DON BUNTING</u> SURVEY IN THE SE'/4 SEC 1-83-4W, RE-ESTABLISHED WI/4 COR BY MEASURING MILE AND USING EVICENCE OF OLD ROAD TO THE WEST, SEARCHED MONU AT NW DOR DIO NOT FIND SET IRON AN USING COUNTY TIES AND EVIDENCE PLAN VIEW


(Show a minimimum of three reference ties to durable physical objects, relevant monuments and physical conditions that will enable recovery of the corner.)

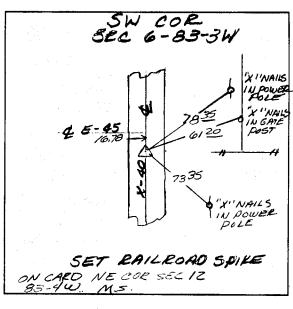

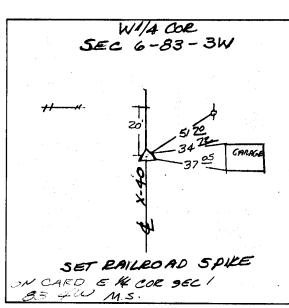

0

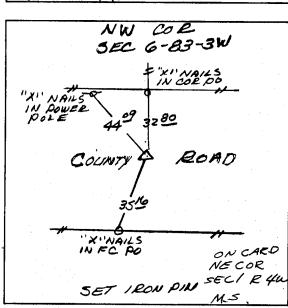

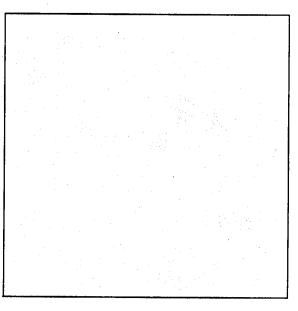

I hereby certify that the survey work was completed and this certificate was prepared by me or under my direct personal supervision and that I am a duly registered land surveyor under the laws of the state of lowa. My registration expires December 31, 19

Signature: Sany R. McGuire

LARRY R. McGUIRE

Date: 5/7/92 Reg. No. 9019



LAND	CORNERS	TO BE	RECORDED
Corners	Section	Twp.	Range
SWCOR	6	83	3W
W14 COR	6	83	3W
NWCOR	6	83	3W