Instrument #: 2025-2549
10/09/2025 03:58:08 PM Total Pages: 1
ZSC SECTION CORNER CERTIFICATE
Recording Fee: \$7.00 Transfer Tax: \$0
Sheri L. Jones, Recorder, Jones County Iowa

MINISTER STANDARD PROPERTY SECTIONS NEWSFILMS MINISTER

PREPARED BY MICHAEL J. WEBER, WEBER SURVEYING, LLC, 26789 46TH AVE, BERNARD, IA 52032 (563) 879-4173

UNITED STATES PUBLIC LAND SURVEY CORNER CERTIFICATE OF


LAND SURVEY MONUMENTS SITUATED IN SECTION 8, TOWNSHIP 86 NORTH, RANGE 3 WEST OF THE FIFTH PRINCIPAL MERIDIAN, JONES COUNTY, IOWA.

PREVIOUSLY RECORDED SEE NOTES BELOW

Goods, page, document number, etc.)

(Show reason for preparing this certificate, the evidence and detailed procedures used in establishing the corner positions and monumentation found or placed)

Monument Description and Remarks:
-WEST 1/4 CDR., SEC. 8, T86N R3W DF THE 5TH P.M. FOUND 1/2" DIA. REROD
PREVIOUSLY RECORDED IN COR. CERT. INSTR. NO. 9798 3333
-SW CDR., NW-NW, SEC. 8, T86N R3W DF THE 5TH P.M. PLACED 5/8" DIA.
REROD W/DRANGE CAP NO. 15084 PREVIOUSLY RECORDED IN COR. CERT. INSTR.
NO. 2008 1333 INDEXED AS THE SE COR., NE-NE, SEC. 7, T86N R3W DF THE
5TH P.M.

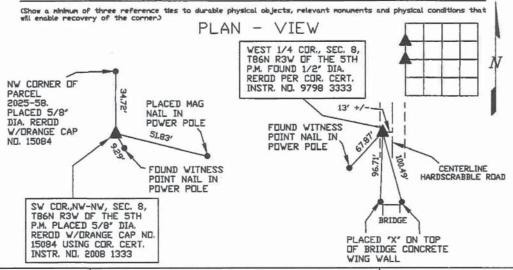



I HEREBY CERTIFY THAT THIS LAND SURVEYING DOCUMENT VAS PREPARED AND THE RELATED SURVEY VORK VAS PERFERRED BY ME OR UNDER HY DIRECT PERSONAL SUPERVISION AND THAT I AM A DULY LICENSED LAND SURVEYOR UNDER THE LAVS OF THE STATE OF IDVA.

MICHAEL J. VEBER/
LICENSE NUMBER 15004

MY LICENSE RENEVAL DATE IS DECEMBER 31, 2025
SHEETS COVERED BY THIS SEAL . This , Shock

List Corners to be Indexed
Corner Sec Tup Range

WEST 1/4 COR., 8-86N-3W SW COR., NV-NW 8-86N-3W

DWG. 25092

FEEBOOK: 2008 1333 5/2/2008 2:55 PM

REC FEES: \$7.00

PAGES: 1

Marie Krutzfield, Recorder Jones County, Iowa


Prepared by Wm. Burger LandSurveyors 510 3rd Street West Court, Worthington, Jown

UNITED STATES PUBLIC LAND SURVEY CORNER CERTIFICATE Land Survey Monuments situated in Section 7. Township 86N, Range 3W, of the Fifth Principal Meridian, Jones County, Iowa. Previously recorded in _____N/A ___ in the Office of the County Recorder Monument Description and Remarks: (No Corner Certificates found at the County Recorders Office) NE CORNER - FOUND LIMESTONE WITH 5/8' IRON ROD ON NORTH & SOUTH SIDE OF LIMESTONE SE CORNER NEI/4 NEI/4 - SET 1/2" IRON ROD W/YELLOW LS CAP #12642 - SET DN LINE AND MIDWAY BETWEEN THE E1/4 CORNER AND THE NE CORNER SW CORNER NE1/4 NE1/4 - SET 1/2' IRON ROD W/YELLOW LS CAP #12642 - RUN STRAIGHT LINES FROM OPPOSITE 1/4 1/4 SECTION CORNERS AND SET AT THE POINT OF INTERSECTION PLAN VIEW NE CORNER SE CORNER NE1/4 NE1/4 SET NAIL W/ WITNESS DISK ON TOP OF WOOD POST AND AT STEEL POST FD. NAIL W/ RIBBON AT CORNER POST PARCEL 2008-37 PARCEL 2008-38 1/2" IRON ROD W/ — YELLOW LS CAP #12642 POST R.D.W. LINE 19.63 STEEL 10.08 CORNER POST SET 1/2' IRON ROD W/-YELLOW LS CAP #12642 >0.46 53,58 FD. LIMESTONE W/ 5/8' RDD ON NORTH & SOUTH SIDE SET NAIL W/ WITNESS DISK ON TOP OF BRACE POST AND AT POWER POLE POWER SW CORNER NE1/4 NE1/4 SET NAIL W/ WITNESS DISK ON TOP OF POST AT ALL TIE POINTS BRACE HARDSCRABBLE ROAD SET 1/2" IRON ROD W/ YELLOW LS CAP #12642 VOOD POST 15 13 CORNERS TO BE INDEXED



SEC. 7 TWP. 86N RANGE 3W

SĘ	CURNER	NE1/4	NE1/4	7	86N	34
sw	CORNER	NE1/4	NE1/4	7	86N	34

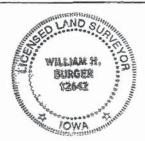

I hereby certify that this land surveying document was prepared and related survey work was performed by me or under my direct personal supervision and that I am a duly licensed Land Surveyor under the laws of the State of Iowa.

William H William H. Burger

License number 12642

My license renewal date is December 31, 2008 Pages or Sheets covered by this seal: Sheet 1 of 1