2001 0114
FILED
RECORDERS OFFICE
JONES COUNTY 10WA

01 JAN 11 PM 3: 32

MARIE KRUTZFIELD RECORDER 6.00 pd

CLARENCE J. WALTON, LS # 11310, WALTON LAND SURVEYING, P.C., 2213 LAUREN DR. SW, CEDAR RAPIDS, IOWA 52404, (319) 363-4271 UNITED STATES PUBLIC LAND SURVEY CORNER CERTIFICATE LAND SURVEY MONUMENTS SITUATED IN SECTION 21, TOWNSHIP 83 NORTH, RANGE 1 WEST OF THE 5TH PRINCIPAL MERIDIAN, JONES COUNTY, IOWA **NE CORNER** E 1/4 CORNER FOUND SPIKE IN CORNER POST SIDEWALK T AVENUE NORTH 2ND STEEL POST FROM FENCE CORNER TO WEST 4TH STEEL POST FROM FENCE CORNER TO WEST CENTERLINE OPERATING NUT OF FIRE HYDRANT FOUND SPIKE IN CORNER POST SIDEWALK 22.70 \_60.10i FOUND 5/8" REBAR N CONCRETE FOUNDATION CORNER CENTERLINE SANITARY MANHOLE CONCRETE FOUNDATION CORNER BUILDING BUILDING FOUND X'D NAILS IN UTILITY POLE MONUMENT DESCRIPTION AND REMARKS MONUMENT DESCRIPTION AND REMARKS FOUND 5/8" BORE REBAR 8" DEEP PER TIES FROM JONES COUNTY ENGINEERING DEPARTMENT RECORDS. SET PK SPIKE IN ASPHALT PER TIES FROM JONES COUNTY ENGINEERING DEPARTMENT RECORDS. NOTE: ALL MEASUREMENTS IN FEET AND DECIMALS THEREOF. CLAP CLAP I hereby certify that this land surveying document and the related survey work was performed by me or under my direct personal supervision and that I am a duly licensed Land Surveyor under the laws of the State of lowa.


Signed

Date CORNERS TO BE INDEXED CORNERS SECTION CLARENCE ΝÆ 21 83N E 1/4 21 WALTON Clarence J. Walton, L.S.
My License Renewal Date is December 31, 2001
License Number 11310
Pages or sheets covered by this seal: 01/10/01 11310 AWO1 PROJECT Book: 0060-3B UNITED STATES
PUBLIC LAND WALTON LAND SURVEYING, P.C. CJW 1 2213 LAUREN DRIVE SW <u>×</u> SURVEY CORNER CEDAR RAPIDS, IOWA 52404 Scale: 11/9/00 NONE CERTIFICATE (319) 363-4271

## LAND CORNER SURVEY CERTIFICATE

SECTION CORNER COMMON TO SECTIONS 15, 16, 21 and 22 TOWNSHIP 83 North, Range 1 West, Jones County, Iowa

Oxford NE Sec. 21

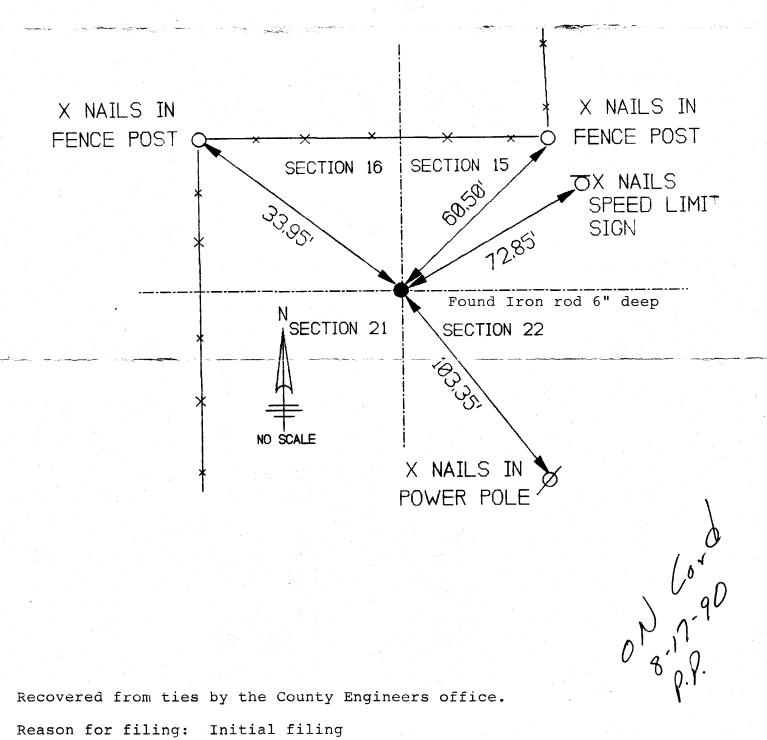

Recovered from ties by the County Engineers office.

Reason for filing: Initial filing

## CERTIFICATION

I hereby certify that this plat and survey was made by me or under my direct personal supervision and that I am a duly Registered Land Surveyor under the laws of the State of Iowa.

Reg# 6581 8/3/90 Harold E. Dillon