Instrument #: 2018-3497
12/31/2018 09:16:39 AM Total Pages: 1
ZSC SECTION CORNER CERTIFICATE
Recording Fee: \$7.00 Transfer Tax: \$0
Sheri L. Jones, Recorder, Jones County Iowa

NYON, IRONO, HONO, KANTONIKA NATAWAR, DIPARI, IPOKARANIA. I

Prepared by & Return to: Herold - Reicks Surveying, 10 East Main Street, New Hampton, IA 50659, Ph. 641-394-2725

United States Public Land Survey Corner Certificate

Land Survey Monument situated in

Section 18, Township 83 North, Range 3 West of the Fifth Principal Meridian, Jones County, Iowa. On file in **Document #2008-1311** in the County Recorder's office.

This certificate is being prepared in compliance with Iowa Code Chapter 355.11 because:



There is no certificate on file for this corner.

There are no longer three valid ties of record.

There are changes to reference ties of record. There is change of monumentation of record.


To clarify description of record monument (ties).

Monument Description and Remarks:

Northeast Corner NW 1/4-NW 1/4: Found 5/8" pebar with orange plastic cap PLS 14807 with information obtained from the previously recorded Section Corner Certificate. Reset with 1"Ø Bronze Survey Marker PLS 19211 with coordinates obtained prior to highway reconstruction. Corner being reset in conjunction with Project No. FM-TSF-CO53(86)--5B-53.

Plan View

(Show a minimum of three reference ties to durable physical objects, relevant monuments and physical conditions that will enable recovery of the corner.)

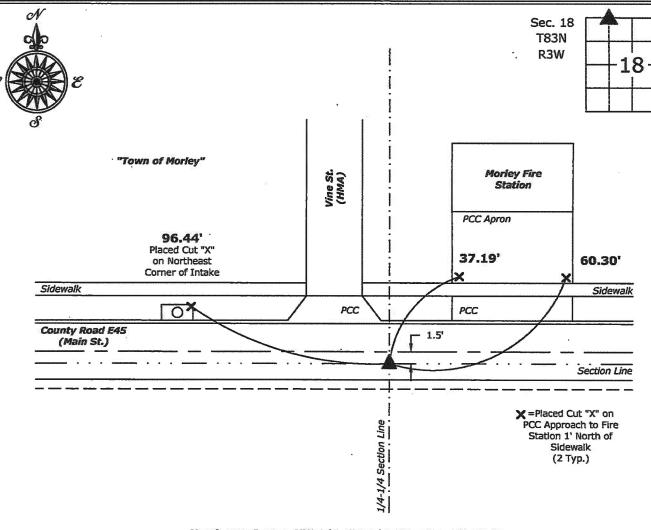

Northeast Corner NW 1/4-NW 1/4 of Section 18-83-3 Set 1"Ø Bronze Survey Marker PLS 19211

I hereby certify that this land surveying document

was prepared and the related survey work was performed by me or under my direct personal supervision and that I am a duly licensed Land Surveyor under the laws of the State of Iowa.

Kirk D. Reicks

KIRK D.

19211

12-27-18 Date:

License number 19211

My license renewal date is December 31, 2020. Sheets covered by this seal: Individual sheet only

List Corner to be Indexed

Section Twp. Corner Range NE-NW-NW 18 83

Project Number: 2018-828 FB: 2018 Construction, Pgs. 13-15

Projects - NHO\2018\2018-828 Jones-E45 PCC\2018-828.dwg, 12/27/2018 9:47:08 AM ii

Marie Krutzfield, Recorder Jones County, Iowa

52205 (319)462-3785

J.D. TJEPKES, LS. JONES COUNTY ENGINEER'S OFFICE, 19501 HWY. 64, ANAMOSA, IOWA, 52205 (319)462-3785

UNITED STATES PUBLIC LAND SURVEY CORNER CERTIFICATE

LAND SURVEY MONUMENTS SITUATED IN SECTION $\underline{18}$, TOWNSHIP $\underline{83}$ NORTH, RANGE $\underline{3}$ WEST OF THE 5TH P.M., JONES COUNTY, IOWA

CORNERS TO BE INDEXED	CORNERS TO BE INDEXED
CORNER SECTION TOWNSHIP RANGE NE COR. 18 83N 3W NW1/4-NW1/4 NO SCALE	CORNER SECTION TOWNSHIP RANGE SW COR. 18 83N 3W NE1/4-NW1/4
OFFICE FILE NO. MORLEY FIRE STATION	OFFICE FILE NO.
CORNER	FD P/C NE COR. NW-NW SEC. 18
SURVEY DISK	NW-NW SEC. 18 NW-NW SEC. 18 SET 5/8"/24" REBAR W/ORANGE
POWER POLE CENTER No. 15 FIRE HYD	FD P/C NW
COVER SI	NE1/4-NW1/4 SEC S87*01*29*W
13.08	1218.97'
CL E-45 SET 5/8"X24" REBAR	PI CL SS OPEN OPEN
W/ORANGE CAP #14807 2 2' SOUTH OF CL E-45 FIELD NOTES: MISC	CULTIVATED FIELD FD P/C CENTER FIELD NOTES: MISC SEC 18 FIELD NOTES: MISC SEC 18
12' EAST OF CL VINE STREET BOOK 2002-2003 PAGE 79 4-29-2008	FD P/C W1/4 PAGE 80 SEC 18 4-29-2008
PREVIOUSLY RECORDED IN BOOK NA , PAGE NA	PREVIOUSLY RECORDED IN BOOK NA PAGE NA MONUMENT DESCRIPTION AND HOW ESTABLISHED
MONUMENT DESCRIPTION AND HOW ESTABLISHED_ PER BREAKDOWN OF THE NORTHWEST QUARTER OF SECTION 18 T83N R3W, SET 5/8"X24" REBAR W/ORANGE CAP #14807,	PER BREAKDOWN OF THE NORTHWEST QUARTER SECTION 18 T83N R3W, SET 5/8"X24" REBAR W/ORANGE CAP #14807 AND A MAGNET IN OPEN
DRILLED INTO CONCRETE PAVEMENT. TIES AS INDICATED FOR THE NORTHEAST CORNER NW1/4-NW1/4 SEC 18 T83N R3W.	CULTIVATED FIELD, BURIED 18". TIES AS INDICATED FOR THE SOUTHWEST CORNER OF THE NE1/4-NW1/4 SECTION 18 TB3N R3W.
CORNERS TO BE INDEXED	CORNERS TO BE INDEXED
CORNER SECTION TOWNSHIP RANGE OFFICE FILE NO.	CORNER SECTION TOWNSHIP RANGE
NO SCALE	QFFICE_EILE_NQ. NO SCALE
PREVIOUSLY RECORDED IN BOOK, PAGE	555 4614514 55555555 31 5554
MONUMENT DESCRIPTION AND HOW ESTABLISHED	PREVIOUSLY RECORDED IN BOOK, PAGE MONUMENT DESCRIPTION AND HOW ESTABLISHED
I hereby declare that this plat, survey or repo	ort SEAL J.D. TJEPKES LS 14807
was made by me or under my direct personal supervision and that I am a duly registered L	and ENGINEER'S OFFICE
Surveyor under the laws of the State of lowa	IOSEPH D. 2
510000	TJEPKES 19501 HWY. 64,

Joseph D. Tjepkes L.S. lowa Reg. No. 14807

My Registration Renewal Date is December 31, 2008