Instrument #: 2018-3500

12/31/2018 09:16:39 AM Total Pages: 1

ZSC SECTION CORNER CERTIFICATE

Recording Fee: \$7.00 Transfer Tax: \$0

Sheri L. Jones, Recorder, Jones County Iowa

### BALLY BOLL PROLETY PROLETY PROPERTY (PROFESSOR MANAGEMENT)

#### Prepared by & Return to: Herold - Reicks Surveying, 10 East Main Street, New Hampton, IA 50659, Ph. 641-394-27d **United States Public Land Survey Corner Certificate** Land Survey Monument situated in Section 7, Township 83 North, Range 3 West of the Fifth Principal Meridian, Jones County, Iowa. On file in Document #2016-0336 in the County Recorder's office. There is no certificate on file for this corner. This certificate is being prepared in compliance There are no longer three valid ties of record. There are changes to reference ties of record. with Iowa Code Chapter 355.11 because: There is change of monumentation of record. To clarify description of record monument (ties). **Monument Description and Remarks:** Southeast Corner: Found 5/8"Ø rebar with information obtained from the previously recorded Section Corner Certificate. Reset with 1"Ø Bronze Survey Marker PLS 19211 with coordinates obtained prior to highway reconstruction. Corner being reset in conjunction with Project No. FM-TSF-CO53(86)--5B-53. **Plan View** (Show a minimum of three reference ties to durable physical objects, relevant monuments and physical conditions that will enable recovery of the corner.) Sec. 7 **T83N** R3W 7 **72.74'** Set 5/8"Ø Rebar 2'± East of Stop Sign County Road E45 10.00 Section Line 2 161.12 Fd. Yellow Plastic 149.57 Tag in Northwest Fd. Yellow Plastic Tag in Northeast Side of Power Pole Side of Power Pole Southeast Corner of Section 7-83-3 Set 1"Ø Bronze Survey Marker PLS 19211

KIRK D. REICKS 19211

I hereby certify that this land surveying document was prepared and the related survey work was performed by me or under my direct personal supervision and that I am a duly licensed Land Surveyor under the laws of the State of Iowa. 12-27-18

let Kirk D. Reicks

License number 19211

My license renewal date is December 31, 2020. Sheets covered by this seal: Individual sheet only

Date:

	LIST COLLICI	to be midexed	
Corner	Section	Twp.	Range
SE	7	83	3

Project Number: 2018-828 FB: 2018 Construction, Pgs. 13-15 Projects - NHO\2018\2018-828 Jones-E45 PCC\2018-828.dwg, 12/27/2018 9:47:40 AM

Instrument #: 2016-0336
02/05/2016 12:11:33 PM Total Pages: 1
2SC SECTION CORNER CERTIFICATE
Recording Fee: \$7.00 Transfer Tax: \$0
Sheri L. Jones, Recorder, Jones County Iowa 2016-0336

## 

PREPARED BY: RANDALL L. RATTENBORG. 105 WEST MAIN STREET. MANCHESTER, IA. 52057, 563-927-2434

#### UNITED STATES PUBLIC LAND SURVEY CORNER CERTIFICATE

Land Survey Monuments situated in Section <u>7</u>, Township 83 North, Range 3 West of the Fifth Principal Meridian, Jones\_ \_\_ County, lowa.


Previously recorded in County Recorder's Office in

Not Recorded

SE CORNER, Found 5/8" iron rod in P.C.C. Pavement 10' south of centerline.

#### **PLAN VIEW**


(Show a minimum of three reference ties to durable physical objects, relevant monuments and physical conditions that will enable recovery of the corner.)

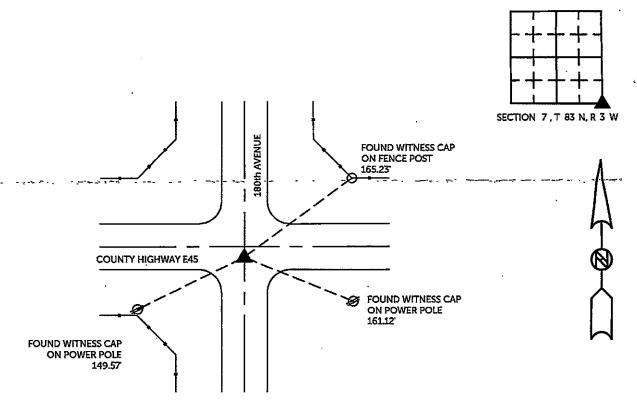

SE CORNER FOUND 5/8" IRON ROD IN P.C.C. PAVEMENT

TIES ARE TO PLAT PARCEL 2 IN SECTION 7, T 83 N, R 3 W PARCEL 2016-09

BURRINGTON GROUP, INC. PROJECT NO.15-129

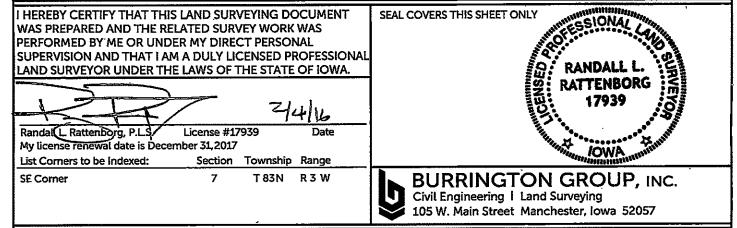

2001 3966

FILED RECORDERS OFFICE JONES COUNTY IOWA

83318e-11/201 ID# 566 MARIE KRUTZFIELD RECORDER No Fee

J.D. TJEPKES, LS. JONES COUNTY ENGINEER'S OFFICE, 19501 HWY. 64, ANAMOSA, IOWA, 52205 (319)462-3785

## UNITED STATES PUBLIC LAND SURVEY CORNER CERTIFICATE

LAND SURVEY MONUMENTS SITUATED IN SECTION 18, TOWNSHIP 83 NORTH, RANGE 3 WEST OF THE 5TH P.M. JONES COUNTY JOWA

NORTH, RANGE 3 WEST OF THE 5TH	P.M., JONES COUNTY, IOWA					
CORNERS TO BE INDEXED  CORNER SECTION TOWNSHIP RANGE NORTHEAST 18 83N 3W  OFFICE FILE NO. JONES COUNTY FIELD BOOK MISC. 2000	CORNERS TO BE INDEXED  CORNER SECTION TOWNSHIP RANGE  OFFICE FILE NO.  NO SCALE					
SET PLASTIC SURVEY DISK IN FENCE POST  COUNTY ROAD  (E-45)  SET PLASTIC SURVEY DISK IN FENCE POST  SET 5/8"X24" REBAR  WITH YELLOW CAP LS 14807, IN PAVEMENT. NE COR. SEC.  18-83-3  SET PLASTIC SURVEY DISK IN POWER POLE SURVEY DISK IN FENCE POST PREVIOUSLY RECORDED IN BOOK N/A , PAGE N/A PAVEMENT AT STA. 33+86, 6.6" RT. DONALD THOMAS USED THIS COR. FOR PLAT OF SURVEY & FILED TIES WITH JONES COUNTY ENGINEER. DRILLED HOLE, SET	PREVIOUSLY RECORDED IN BOOK, PAGE MONUMENT DESCRIPTION AND HOW ESTABLISHED					
5/8"X24" REBAR WITH CAP LS 14807 IN PLACE OF CROSS. SET REFERENCE PTS AND TIED OUT AS INDICATED. NE. COR. SEC. 18, T83N, R3W, 5TH P.M., JONES COUNTY, IOWA  CORNERS TO BE INDEXED  CORNER SECTION TOWNSHIP RANGE  OFFICE FILE NO.  NO SCALE	CORNERS TO BE INDEXED  CORNER SECTION TOWNSHIP RANGE  OFFICE_FILE_NQ					
PREVIOUSLY RECORDED IN BOOK, PAGE MONUMENT DESCRIPTION AND HOW ESTABLISHED	PREVIOUSLY RECORDED IN BOOK, PAGE MONUMENT DESCRIPTION AND HOW ESTABLISHED					
I hereby declare that this plat, survey or report was made by me or under my direct personal supervision and that I am a duly registered Land Surveyor under the laws of the State of lowa.  Signed  SEAL MAND SURVEY  J.D. TJEPKES LS 14807  JONES COUNTY  ENGINEER'S OFFICE						
Signed  TJEPKES  19501 HWY. 64, ANAMOSA, IOWA, 52205 (319)462-3785  Wy Registration Renewal Date is December 31, 2002						

# UNITED STATES PUBLIC LAND SURVEY CORNER CERTIFICATE

of

Land Survey Monuments situated in Section	, Township, Range, County, Iowa.
Previously recorded in	in County Recorder's Office.
(Show reason for preparing this certificate, the evidence and detailed promentation found or placed.)  Monument Description and Remarks:   WED IN A PLAT OF SURVEY,  TOWA.	PARKEL A, JONES COUNTY,
	DALF WOODER
	DAVE ACKEPOLIAN
PLAN - VII (Show a minimum of three reference ties to durable physical objects, rele	
recovery of the corner.)	
	LE-15
FD. CHISEL NAPL SOP G. SIR. 329 +86. ZE, SUNI POST DETECTION BELOW	SIUN POST 33 DE LES LES LES LES LES LES LES LES LES LE
CONL	FD 2" PIPE EUPOIED  ""   SO". SET /2" IB. # 6019  OVER PIPE  104.4'  104.4'
ME CCP, NW	104.4 COPY POST VINCEP CIPAINID  CRELE WAY-NING FEST  4 SECT. 17-825-25
I hereby certify that the survey work was completed and this certificate was prepared by me or under my direct personal supervision and that I am a duly-registered land surveyor under the laws of the state of lowards.  Signature: **Londa   A. ** Morras   Nume typed or printed:  Date: *  12-18-9   Reg. No. 6019	List Corners to be Indexed Corners Section Twp Range  No. 17 825 35  N/4 ceth. 17 825 35
SEAL GOISTER ON A COUNTY OF SURVEYOR SU	Rone