2000 0827

FILED RECORDERS OFFICE JONES COUNTY IOWA




00 MAR 10 AM 8: 35

MARIE KRUTZFIELD RECORDER NO FEE

JONES COUNTY ENGINEER, 19501 HWY. 64, ANAMOSA, IOWA

UNITED STATES PUBLIC LAND SURVEY CORNER CERTIFICATE

LAND SURVEY MONUMENTS SITUATED IN SECTION 32, TOWNSHIP 83 NORTH, RANGE 3 WEST OF THE 5TH P.M., JONES COUNTY, IOWA

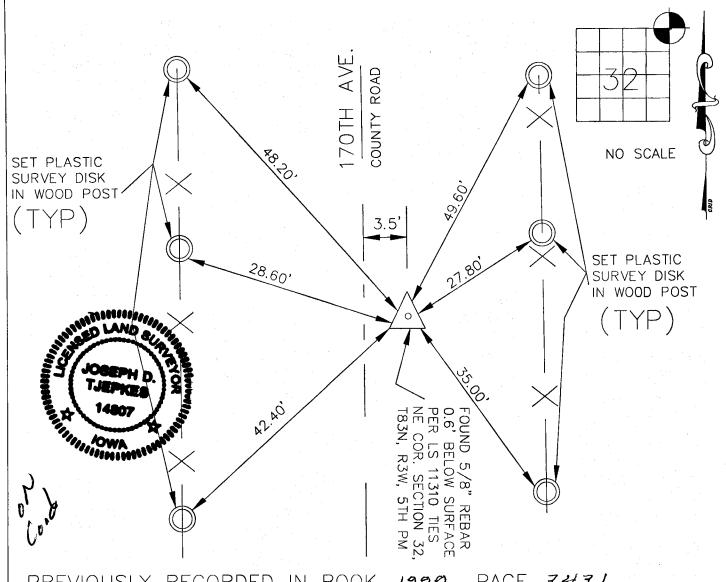

PREVIOUSLY RECORDED IN BOOK 1990, PAGE 343/
MONUMENT DESCRIPTION AND HOW ESTABLISHED FOUND
5/8" REBAR 0.6' BELOW ROAD SURFACE PER TIES FROM CORNER CERTIFICATE
LS 11310 AS RECORDED IN BOOK AND PAGE AS INDICATED ABOVE IN THE
JONES COUNTY RECORDERS OFFICE. SET NEW TIES AS INDICATED TO
PERPETUATE MONUMENT.

I hereby declare that this plat, survey or report was made by me or under my direct personal supervision and that I am a duly registered Land Surveyor under the laws of the State of Iowa.

Signed:

J. 1990 3-12-200

Joseph B. Tjepkes L.S. lowa Reg. No. 14807 My Registration Renewal Date is December 31, 2000

CORNERS TO BE INDEXED

CORNER SECTION TOWNSHIP RANGE

NE 32 83N 3W

JONES COUNTY ENGINEER
10501 HWY, 61,
ANAMOSA, IOWA

1999 3431 FILED RECORDERS OFFICE JONES COUNTY IOWA

99 SEP 23 AM 10: 58

MARIE KRUTZFIELD RECORDER 6.00 Pd

BRAIN ENGINEERING, INC., 777 10TH STREET, MARION, IOWA 52302 PH. (319) 373-1318

STATES PUBLIC LAND UNITED SURVEY CORNER CERTIFICATE LAND SURVEY MONUMENTS SITUATED IN SECTION 32, TOWNSHIP 83 NORTH ___JONES_____ COUNTY, IOWA. RANGE _3_ WEST OF THE 5TH P.M., ___ NO SCALE NE CORNER FOUND FOUND AVE REDHEAD REDHEAD IN TOP OF IN TOP OF 49.96 170TH FENCE 48 FENCE POST POST 42,55 35,25 FOUND FOUND REDHEAD REDHEAD TOP OF IN TOP OF FENCE **FENCE** WALTON 11310

VALTON 11310

IN BOOK POST POST PREVIOUSLY RECORDED IN BOOK _____ PAGE ____ PREVIOUSLY RECORDED IN BOOK _____ PAGE . MONUMENT DESCRIPTION AND HOW ESTABLISHED MONUMENT DESCRIPTION AND HOW ESTABLISHED FOUND 5/8" REBAR 7" BELOW ROAD CORNERS TO BE INDEXED CORNER SECTION TOWNSHIP RANGE I hereby declare that this plat, survey or report was made by me or under my direct personal supervision and that I am a duly registered Land Surveyor under the laws of the State of Iow NE CORNER T83N R3W BRAIN ENGINEERING, INC. Date Clarence J. Walton L.S. Iowa Reg No. 11310
My Registration Renewal Date Is December 31, 1999 777 10TH STREET MARION, IOWA 52302 23289-10 (319) 37**3-1318**

SECTION CORNER CERTIFICATE		
	LAND SURVEY MONUMENTS SITUATED IN SECTION 33, TO RANGE 3 WEST, OF THE FIFTH PRINCIPAL MERIDIAN, Jones	
	PREVIOUSLY RECORDED IN BOOK AT PAGE	FOR RECORDER'S USE
REASON FOR PREPARING CERTIFICATE:		
A)	THERE IS NO CERTIFICATE FOR THE CORNER ON FILE WITH THE RECORDER OF THE COUNTY IN WITCH THE CORNER IS LOCATED.	
□ B)		
□ C)		
INCORRECT.		
MONUMENT DESCRIPTION AND REMARKS: NW CORNER - FOUND 5/8"x 24" IRON PIN PROBED UNDER PIN DOWN 2' FOUND NOTHING		
PIN WAS USED AS CORNER BY LAND SURVEY IN 1988		
N 1/4 CORNER - DUG LARGE AREA IN CORNER LOCATION FOUND NOTHING SET 1"x 4'		
IRON PIN BURIED 8" AND 3.7 FEET EAST OF NORTH SOUTH FENCE.		
DECEMENT THE DOLLING		
RECOVERY TIE DRAWING		
NW COR. SEC 33 T83N R3W N 1/4 COR SEC 33 T83N R3W		
		angle from
		Ent.
	B 38.85′ 28.43′ B 3 1 1 1 1 1 1 1 1 1 1 1 1 1 1 1 1 1 1	Post of the second of the seco
	SCAL SCAL	3.7' 1'x 4' rebar
		burled 8'
	원	168
	iron Pin	Corner Post
Distance	e slope meas, 2-25-93 ON CARD NE 32	
CERTIFICATION M.S. CERTIFICATION		
	I,GLEN D. MEISNER, — CERTIFY THAT THE CORNER LOCATION(S) SHOWN RECORD WERE DETERMINED BY ME OR UNDER MY DIRECTION AND CONTINUE OF THE CORNER LOCATION (S) SHOWN RECORD WERE DETERMINED BY ME OR UNDER MY DIRECTION AND CONTINUE OF THE CORNER LOCATION (S) SHOWN RECORD WERE DETERMINED BY ME OR UNDER MY DIRECTION AND CONTINUE OF THE CORNER LOCATION (S) SHOWN RECORD WERE DETERMINED BY ME OR UNDER MY DIRECTION AND CONTINUE OF THE CORNER LOCATION (S) SHOWN RECORD WERE DETERMINED BY ME OR UNDER MY DIRECTION AND CONTINUE OF THE CORNER LOCATION (S) SHOWN RECORD WERE DETERMINED BY ME OR UNDER MY DIRECTION AND CONTINUE OF THE CORNER LOCATION (S) SHOWN RECORD WERE DETERMINED BY ME OR UNDER MY DIRECTION AND CONTINUE OF THE CORNER LOCATION (S) SHOWN RECORD WERE DETERMINED BY ME OR UNDER MY DIRECTION AND CONTINUE OF THE CORNER LOCATION (S) SHOWN RECORD WERE DETERMINED BY ME OR UNDER MY DIRECTION AND CONTINUE OF THE CORNER LOCATION (S) 	Alen D. Merone 1-15-93	W*
GLEN D. MEISNER L.S. NO. 8165 DATE		
G O PROP	SERVICENT CORRECTED SURVEY RECORD SURVEY RECORD 1 30° T/ LS. CAP SER PRODEST	HALL AND HALL ENGINEERS, INC. 226 29TH STREET DRIVE S.E.
D 0 5/8	EXECUTION PERCENTION JONES COUNTY PROJ. LC-714	CEDAR RAPIDS, IDVA 52403
	D RDV C C C C C C C C C C C C C C C C C C C	Ro- LC-714