833070-111201 ID 534

83307e-111201 ID 546

2001 3965 FILED RECORDERS OFFICE JONES COUNTY IOWA


OINOVI6 AMH: 48

MARIE KRUTZFIELD RECORDER No Fee

J.D. TJEPKES, LS. JONES COUNTY ENGINEER'S OFFICE, 19501 HWY. 64, ANAMOSA, IOWA, 52205 (319)462-3785

## UNITED STATES PUBLIC SURVEY CORNER

LAND SURVEY MONUMENTS SITUATED IN SECTION\_7, TOWNSHIP\_83

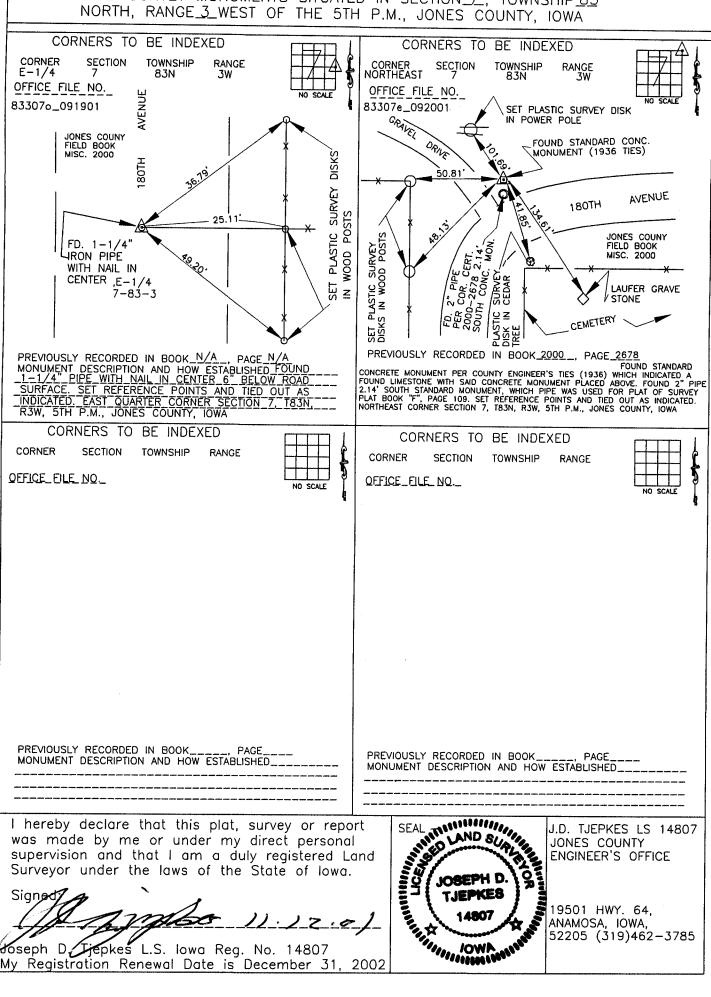


11.12.01

Tjepkes L.S. Iowa Reg. No. 14807

My Registration Renewal Date is December 31,

## UNITED STATES PUBLIC LAND SURVEY CORNER CERTIFICATE

LAND SURVEY MONUMENTS SITUATED IN SECTION\_7\_, TOWNSHIP\_83N NORTH, RANGE\_3\_WEST OF THE 5TH P.M., JONES COUNTY, IOWA

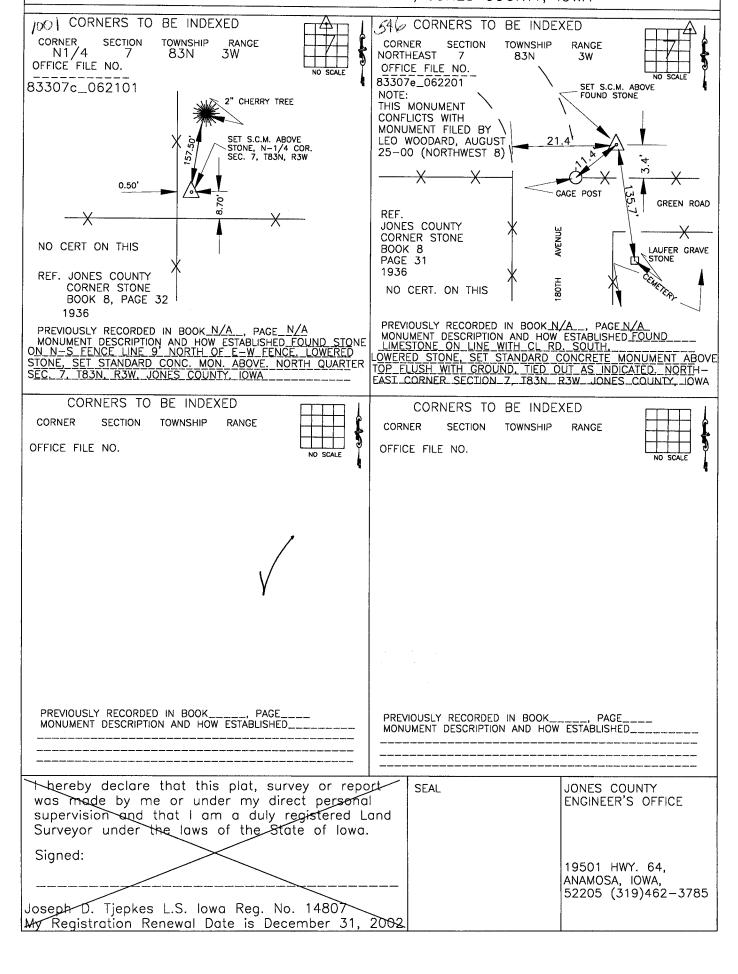

2000 2678

FILED RECORDERS OFFICE JONES COUNTY IOWA


00 AUG 29 AM 11: 25


## MARIE KRUTZFIELD RECORDER

**SLSI 9-90** 

Prepared By: Leo D. Wooder, L.S. #14676 Anderson-Bogert Engineers & Surveyors, Inc.

229 Northland Court N.E. Cedar Rapid UNITED STATES PUBLIC LAND	s, Iowa 52402 Pi	none: (319)	377-4629	
	OF	EK CEKII.	FICATE	
	, Township	83 Jones	North	, Range County, Iowa.
Previously recorded inN/A				corders Office.
(book, page, document number, ect.) (Show reason for preparing this certificate, the evidence and detailed procedures us	od im potablickima the commer.			
Monument Description and Remarks: NW Corner Section 8 W1/4 Corner Section 8-83-3 Found 1 3/4" Pipe	described is assistant	Pipe (descri	ibed in previou	is survey)
SE Corner NE¼ NE¼ Section 8-83-3 Set ½" Iro			76	
Corners used in Plat of Survey #2000-65	ir Rod 117 Ordinge	Cup #140	70	
(Florence E. Duncan Estate)				
PLAN (Show a minimum of three reference ties to durable physical objects, relevant monu-	- VIEW ments and physical condition	s that will enable r	ecovery of the corr	ner.)
NW Corner 8-83-3				: 
Found X Noils in S. Face Power Pole  49.95				
Found X Nails in Wood Corner Post  NW Corner Section 8-83-3 Found 2" Pipe see Plat F-109			SECTION 8	
Top Center 3" Tel. Ped.  Found Double Headed Nail W/ Disk in W. Face 20" Cedar				
Cemetery Cemetery				N
₩¼ Corner 8-83-3	SE Corn	ner NE¼ NE¼	8-83-3	
WW Corner Found Hall & Hall	Set 1/2"	Rebar in Fence lin	o' ± to ditch	
W1/4 Corner Found Hall & Hall			drop off	- -

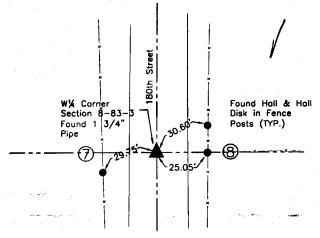

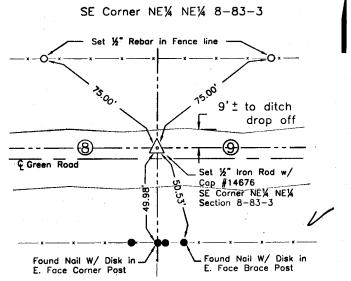

this certific	rtify that the survey work was completed and ate was prepared by me or under my direct pervision and that I am a duly registered land der the laws of the state of lowa.
Signature: Name typed	or printed: Leo D. Wooder
Date:	25/2000 mag, No. 1467 C
SEAL	#14676

Corners	List Corners to Section	be Indexed Twp	Range
NW	8	83 North	3 West
w¼	8	83 North	3 West
SE Corner NE¼ NE¼	8	83 North	3 West

833