
Instrument #: 2015-3126
10/30/2015 10:21:15 AM Total Pages: 1
ZSC SECTION CORNER CERTIFICATE
Recording Fee: \$7.00 Transfer Tax: \$0
Sheri L. Jones, Recorder, Jones County Iowa

## 

Prepared by/Return to: FEHR GRAHAM, 1919 210th Street, Manchester IA 52057 - Ph: (563)927-2060 UNITED STATES PUBLIC LAND SURVEY CORNER CERTIFICATE OF 9 Land Survey Monuments situated in Section \_ \_ , Township \_\_\_ 85 \_ North, Range West of the Fifth Principal Meridian, Jones \_ County, Iowa. Previously recorded in (1) Bk. 2010, Pg. 3410 (2) Bk. 2010, Pg. 3425 in County Recorder's Office. (book, page, document number, etc.) (Show reason for preparing this certificate, the evidence and detailed procedures used in establishing the corner positions and monumentation found or placed.) Monument Description and Remarks: (1) E1/4 Corner of Section 9-T85N-R3W: Section corner information was obtained before and set after concrete overlay project. Found "x" cut in P.C.C. pavement before P.C.C. overlay. Set mag nail in cut "x" in P.C.C. pavement and three new ties. (2) SE Corner of Section 9-T85N-R3W: Section corner information was obtained before and set after concrete overlay project. Found  $5/8" \times 24"$  rebar with orange plastic cap #11310 before P.C.C. overlay. Set mag nail in cut "x" in P.C.C. pavement and four new ties. PLAN VIEW Project Number 15-321 Show a minimum of three reference ties to durable physical objects, relevant monuments and physical conditions that will enable recovery of the corner. Wayne 2 Twp. Set 1/2"ø Rebar Set Orange Plastic Tag #7060 on Power Pole ١ € 170th Street 121.92-103.35 Set 1/2"ø Reba Set Orange Plastic Tag #7060 on Power Pole (1) E1/4 Corner of Sec. 9-T85N-R3W Set Mag Nail in Cut "X" in P.C.C. Pavement (2) SE Corner of Sec. 9-T85N-R3W Set Mag Nail in Cut "X" in P.C.C. Pavement

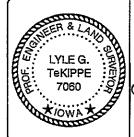

I hereby certify that this land surveying document was prepared and the related survey work was performed by me or under my direct personal supervision and that I am a duly licensed Land Surveyor under the laws of the State of lowa.

yle 9 tekippe, P.E. & P.J. icense Number: 7060 ty license recommendation 10-28-15

license renewal date is December 31, 2016. eets covered by this seal: This Sheet Only

List Corners to be Indexed				
Corners	Section	Twp.	Range	
E1/4	9	85N	ЗW.	
SE	9	85N	ЗW	

G:\C30\15\15-321\15-321-LEGAL.dwg



10

15

NW CORNER

85N

85N

**3W** 

19501 HWY. 64, ANAMOSA, IOWA 52205

Jones County Iowa Marie Krutzfield, Recorder Fee Book 2010 3425

12/09/2010 @0147PM ZSC SEC COR CERT Book: Page: Total Fees: \$0.00


# Pages:

PREPARED BY

CLARENCE J. WALTON, JONES COUNTY ENGINEER'S OFFICE, 19501 HWY. 64, ANAMOSA, IOWA, 52205 (319) 462-3785

## STATES

LAND SURVEY MONUMENTS SITUATED IN SECTION 16, TOWNSHIP 85 NORTH, RANGE 3 WEST OF THE 5TH PRINCIPAL MERIDIAN, JONES COUNTY, IOWA.

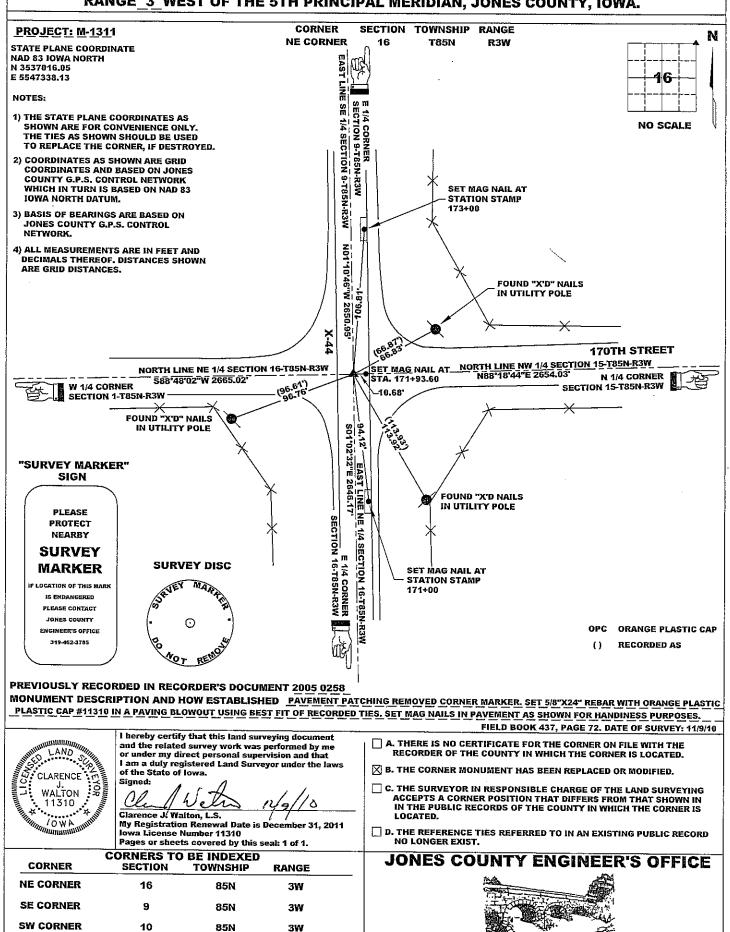


2005 0258

FILED
RECORDERS OFFICE
JONES COUNTY IOWA

## 05 JAN 21 AM 10: 02

MARIE KRUTZFIELD  RECORDER 7.00 pd  PREPARED BY HALL & HALL ENGINEERS, INC. 209 29TH STREET N.E. CEDAR RAPIDS, IOWA 52402 (319) 362-9548						
SECTION CORNER CERTIFICATE OF LAND SURVEY MONUMENTS SITUATED IN SECTION, TOWNSHIP, NORTH, RANGE _3 WEST, OF THE FIFTH PRINCIPAL MERIDIAN,, COUNTY, IOWA.						
			PNORTH, , COUNTY, IOWA.			
PREVIOUSLY RECORDED IN BOOK		_ AT PAGE				
MONUMENT DESCRIPTION AND REMA	ARKS:					
N.E COEHER OF SECTION 16. FOUND 1/2"						
THE OF PEOLICH 16, FOUND 1/2						
	RY TIE DR.	AWING				
HE CORNER OF SECTION 16		NI/4 WANTE	P of SECTION 16			
CHINE CHUER PRE	1111	43	6			
PACT SEL SCHOOL PROPERTY OF THE SELECTION OF THE SELECTIO		1	-012005, tic			
437		•				
A STATE OF THE STA	th.	<del>ntenduksiya dalan dala</del> n qara — ndana — nelediniya dala dalan kushin dalan qara qara qara qara qara qara qara qa	\$ 120 TREET			
2 120 120 1200		A.	FOUND VA A USAN			
SET'X"	•	N. W	PIH U'DEEP			
HAILE & TX HAILS	***	SETX"HAIL	494			
853160-012005. Tre	ļ	LAST HOTE	449			
100 168 - 00 6000 . TOE						
	H					
`	-00-					
I besselve coulder that the besselve and the						
I hereby certify that this land surveying docume the related survey work was performed by me o personal supervision and that I am a duly licens under the laws of the State of lawa.	ne sendar non direct	REASON FOR PREPA	NO CERTIFICATE FOR THE CORNER ON			
DANIEL JE Dunnel James	Date: 1-20-05	IN WHICH	THE RECORDER OF THE COUNTY THE CORNER IS LOCATED. POSITION DIFFERS FROM THAT SHOWN			
Daniel J. Johnson, L.S. 11986 My Reense renewal date is becomber 31, 20 Pages or sheets covered by this seal:	IN THE PUBLIC RECORDS OF THE COUNTY IN HICH THE CORNER IS LOCATED.  IT C) THE CORNER MONUMENT HAS BEEN REPLACED OR MODIFIED.  IT D) THE REFERENCE TIES REFERRED TO IN AN					
(Entire submission unless specified here)						
		EXISTING	PUBLIC RECORD ARE INCORRECT			
L A COMERNMENT CORMER FOLING  E O PROPERTY CORMER FOLING  G O 1/7' X30' W/ LS CAP SET  HALL AND HALL ENGINEERS, INC.						
PROPERTY INE PROPERTY INE LOHES COUNTY C	544/6/FAMHZ		209 29 TH STREET N E. CEDAR RAPIDS, IOWA 52402 (319) 362-9548			
THE SOLU FELL	2/4/99	SCALE	Hate 6			

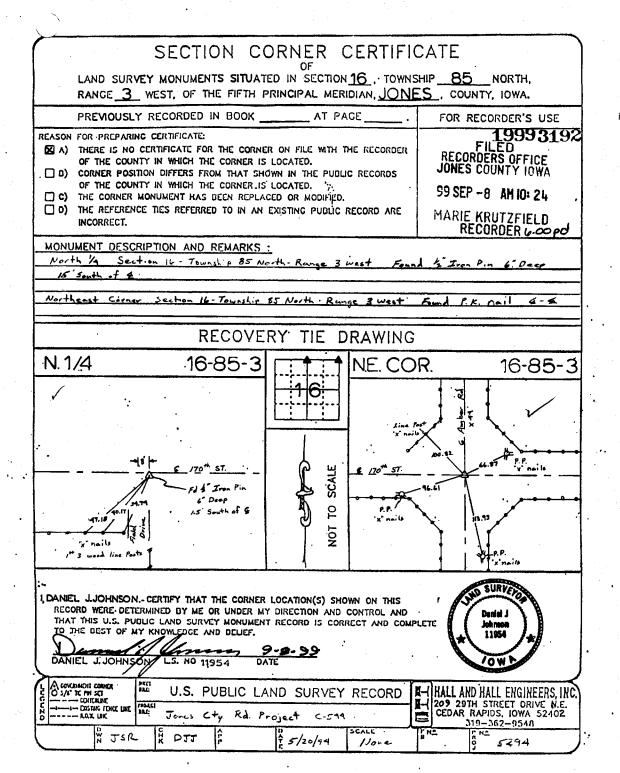

85316c-090899 85316e-090899